

FOR FABRICATION



REV.	COMMENTS	DATE	DRAWN BY	CLARK
V1	FOR FABRICATION	29/11	DESIGNED BY	CLARK
			CHECKED BY	AKO
			APPROVED BY	K.V.KWAN
			DATE	29/11/06
			SCALE	N. T. S.

- DESIGN
- FOR APPROVAL
- CONSULTANT
- AS BUILT
- FINAL DRAWING

AMPOWER

AM-POWER MACHINE INTERPRISE ENTERPRISE CO., LTD.
27, 516 CHUNG-CHENG RD., HSINTECH, TAIPEI, TAIWAN, R.O.C. Tel:(886)-2-2216-9701


PROJECT TITLE
CPC

DRAWING TITLE
PLC CONNECTION DIAGRAM (I)

DRAWING NO.
CPC- PLCI

REV.	W1
SHEET	

12/12

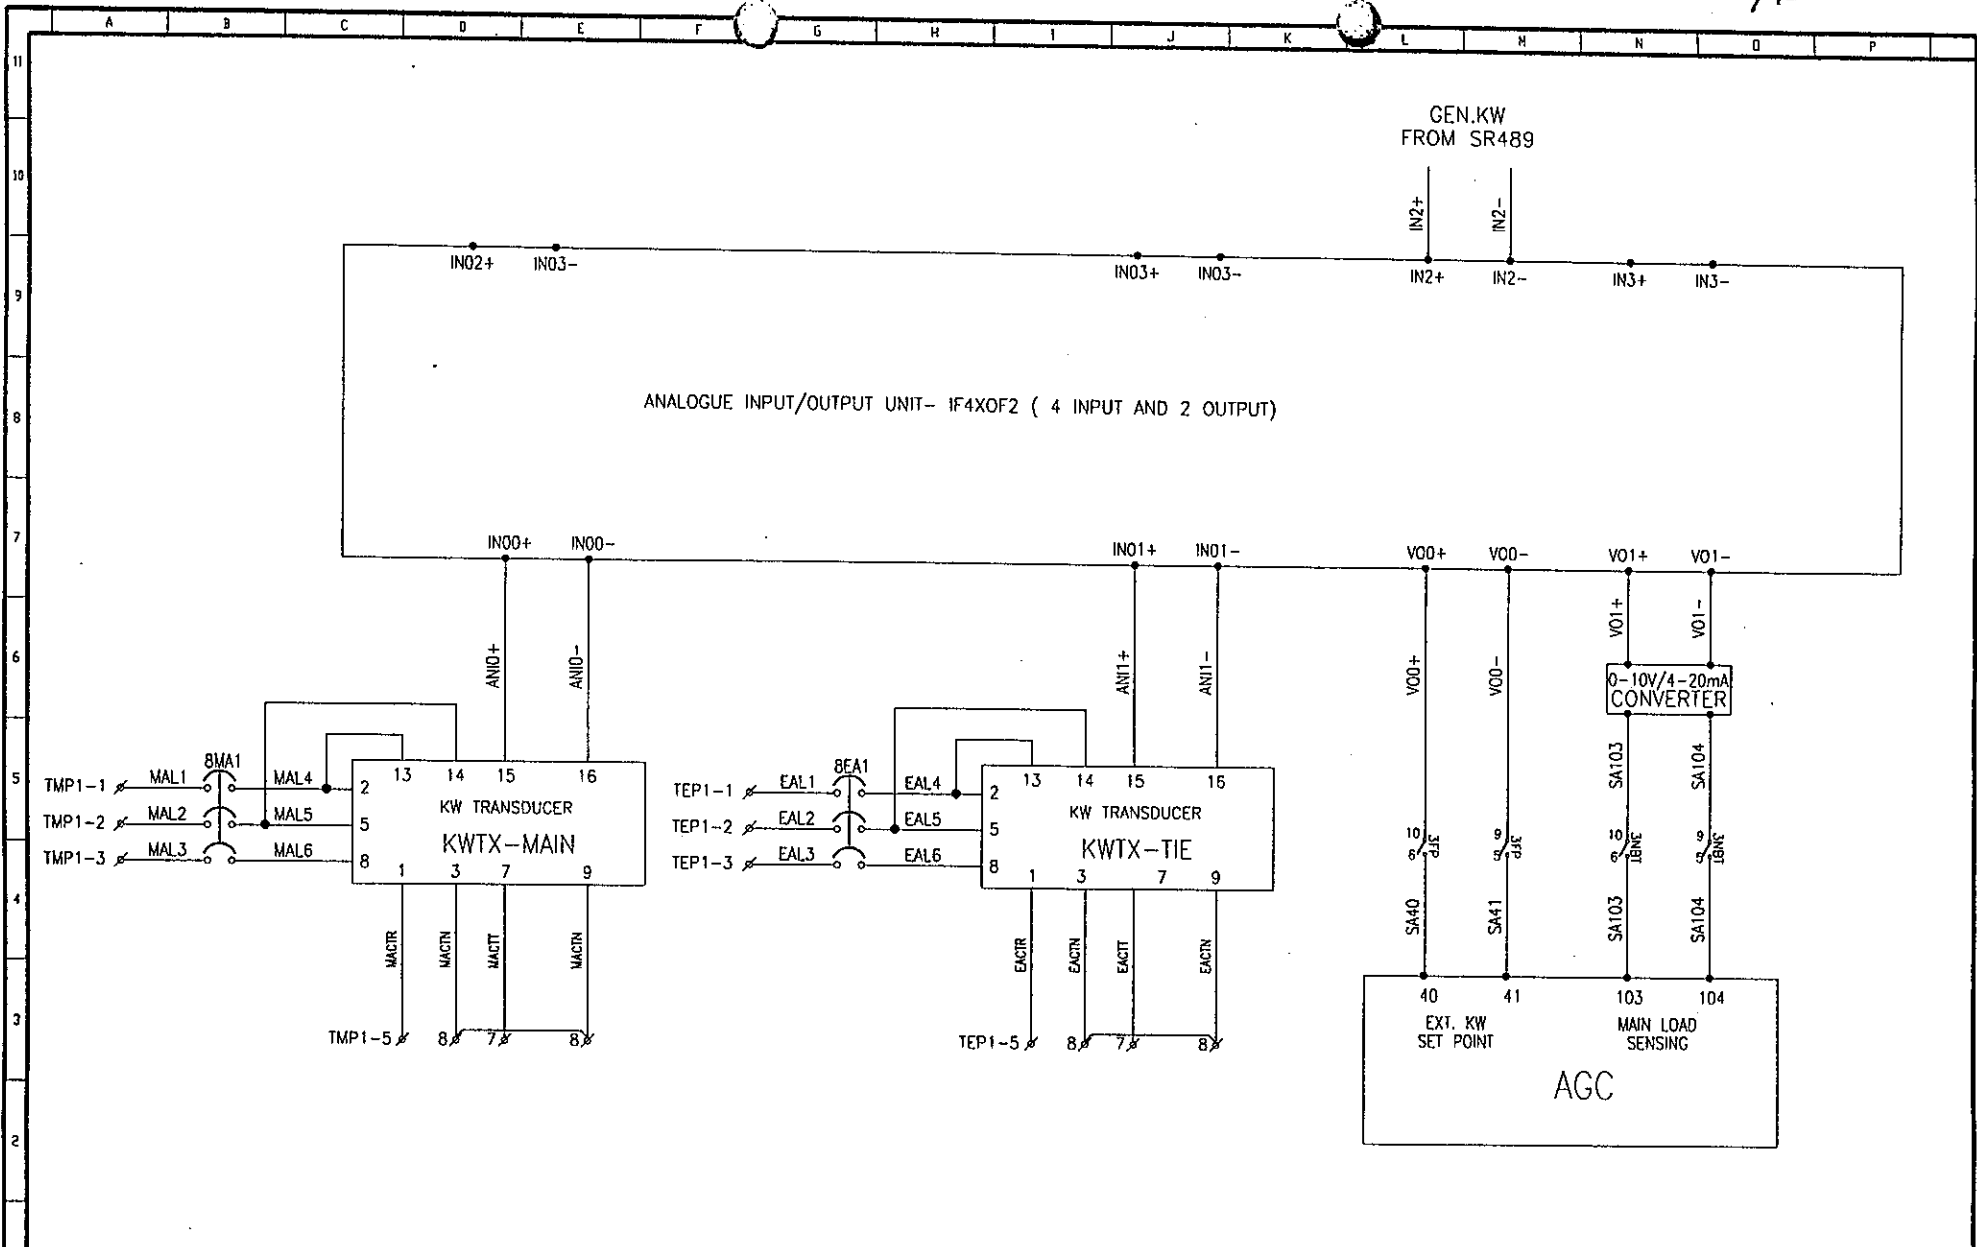

FOR FABRICATION



REV.	COMMENTS	DATE	DRAWN BY	CLARK		
V1	FOR FABRICATION	30/11	DESIGNED BY	CLARK	<input type="checkbox"/> DESIGN	AMPOWER AH-POWER MACHINE ENTERPRISE ENTERPRISE CO., LTD. 2F., 516 CHANG-CHENG RD., NSINTIEN, TAIPEI, TAIWAN, R.O.C. Tel: (886)-2-2218-9701
V2	ADD GENKW INPUT	04/12	CHECKED BY	AKD	<input type="checkbox"/> FOR APPROVAL	
			APPROVED BY	K.W.KWAN	<input type="checkbox"/> CONSULTANT	
			DATE	04/12/06	<input checked="" type="checkbox"/> AS BUILT	
			SCALE	A3 A4	<input type="checkbox"/> FINAL DRAWING	
						PROJECT TITLE CPC DRAWING TITLE PLC AI/D DRAWING NO. CPC-CSL1

REV. V2
SHEET